



Beveridge Williams
development & environment consultants
Melbourne ph: 03 9524 8888

www.beveridgewilliams.com.au

CAD REFERENCE: LND0066101.DWG

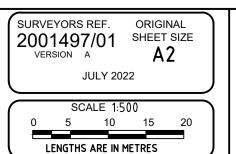

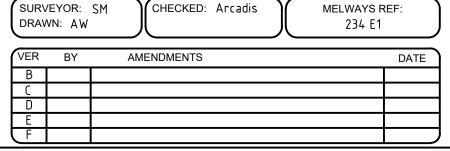

As Constructed Potable Water
UNITY PARK ESTATE - STAGE 1
TARNEIT
File Number: LND/21/00661