

MGA ZONE 55



CAD REFERENCE: LND0066101DWG			
VER	BY	AMENDMENTS	DATE
B			
C			
D			
E			


SURVEYOR: SM
DRAWN: SM

CHECKED: MS

MELWAYS REF:
234-E1

SURVEYORS REF.
2001497/01

VERSION A
JULY, 2022
SHEET 1 OF 1

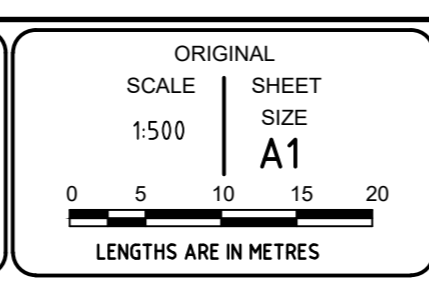

BW Beveridge Williams
development & environment consultants
Melbourne ph : 03 9524 8888
www.beveridgewilliams.com.au

AUTHORITY: GREATER WESTERN WATER
Offer File No: LND/21/00661
PROJECT: UNITY PARK ESTATE, STAGE 1 TARNIT

DETAILS: AS-CONSTRUCTED SEWER