


DETAILS:

AS CONSTRUCTED
RECYCLED WATER

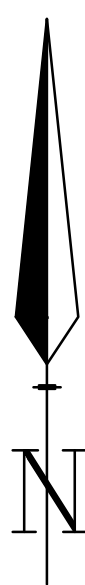

MGA2020 ZONE 55

FOR CONTINUATION SEE SHEET 1

CAD REFERENCE: LND0123311R.DWG			
VER	BY	AMENDMENTS	DATE
B			
C			
D			
E			

SURVEYOR: JH DRAWN: AW
CHECKED: Arcadis
MELWAYS REF: 234 E1

SURVEYORS REF. 2001497/11
VERSION A
MAY 2025
SHEET 2 OF 2

ORIGINAL SCALE 1:500
SHEET SIZE A1
LENGTHS ARE IN METRES



Beveridge Williams

Development and Infrastructure Consultants

Melbourne ph : 03 9524 8888

www.beveridgewilliams.com.au

NOTATIONS:

AUTHORITY: GREATER WESTERN WATER
OFFER FILE NO.: LND/22/01233
PROJECT: UNITY PARK ESTATE, STAGE 11 TARNEIT

DETAILS:
AS CONSTRUCTED RECYCLED WATER