



MGA2020 ZONE 55

LEGEND

INSPECTION OPENING

FOR CONTINUATION SEE PAGE 2

SHEET 1 OF 2

VER	BY	AMENDMENTS	DATE
B			
C			
D			
E			
F			
G			
H			
I			



Beveridge Williams

Development and Infrastructure Consultants

Melbourne ph : 03 9524 8888

www.beveridgewilliams.com.au


CAD REFERENCE: LND0123311.DWG

SURVEYORS REF.
2001497/11

VERSION A
JANUARY 2025
SHEET 1 OF 2

ORIGINAL
SCALE
1:500

SHEET
SIZE
A2

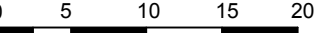

LENGTHS ARE IN METRES

SURVEYOR: JH
DRAWN: AW

CHECKED: Arcadis


MELWAYS REF:
234 E1

CLIENT: GREATER WESTERN WATER

NOTATIONS:

AS CONSTRUCTED SEWER
UNITY PARK ESTATE, STAGE 11
TARNEIT

File Number: LND/22/01233

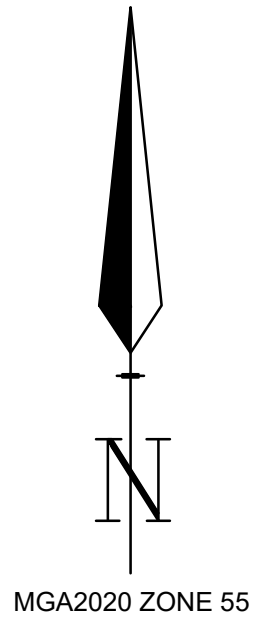

MGA2020 ZONE 55

FOR CONTINUATION SEE PAGE 1

SHEET 2 OF 2

VER	BY	AMENDMENTS	DATE
B			
C			
D			
E			
F			
G			
H			
I			



Beveridge Williams

Development and Infrastructure Consultants

Melbourne ph : 03 9524 8888

www.beveridgewilliams.com.au

CAD REFERENCE: LND0123311.DWG

SURVEYORS REF.

2001497/11

VERSION A

JANUARY 2025

SHEET 2 OF 2

ORIGINAL

SCALE

1:500

SHEET SIZE

A2

0 5 10 15 20

LENGTHS ARE IN METRES

SURVEYOR: JH

DRAWN: AW

CHECKED: Arcadis

MELWAYS REF:

234 E1

CLIENT: GREATER WESTERN WATER

NOTATIONS:

AS CONSTRUCTED SEWER

UNITY PARK ESTATE, STAGE 11

TARNEIT

File Number: LND/22/01233